

BEFORE THE TENNESSEE PUBLIC UTILITY COMMISSION

NASHVILLE, TENNESSEE

October 13, 2023

**IN RE: PETITION OF AQUA GREEN UTILITY INC. CERTIFICATE OF
CONVENIENCE AND NECESSTIY**

DOCKET NO: 21-00084

Petition of Aqua Green Utility Inc. Certificate of Convenience and Necessity

Aqua Green Utility Inc. would like to add to it petition for the Williamson County Recreation Center, as an update.

Plant construction is complete.

Respectfully Submitted,

A handwritten signature in black ink, appearing to read 'Dart Kendall', with a stylized, cursive script.

Dart Kendall
Aqua Green Utility Inc.

FES Consulting, LLC
1031 Robin Lane
Cookeville, TN 38501

October 2, 2023

Williamson County Planning Department
1320 West Main Street
Suite 400
Franklin, TN 37064

RE: Bethesda Road Subdivision

To Whom it May Concern:

The decentralized wastewater treatment plant constructed for the Bethesda Road subdivision, by Aqua Green Utility, appears to have been constructed according to the design plans and specifications. The only changes from the design plans were the orientation and approximate location of the secondary treatment components as indicated on the as-built plans. The plant has been approved by the Tennessee Department of Environment and Conservation (TDEC) Department of Water Resources.

Sincerely,


Bob Faulhaber, PE
rnfaulhaber@gmail.com

As-built changes. All other locations are per original plans.

Pump Tank
Treatment Plant
Secondary Treatment
Sludge Tank

NOTES:
Drip Field pressure and return mains are 2" Sch 40 PVC.

FES Consulting	
Project No.	100-0000000000000000
Client	Bethesda Road Subdivision
Drawn by	Robert N. H. H.
Checked by	Robert N. H. H.
Approved by	Robert N. H. H.
Date	1/20/2020

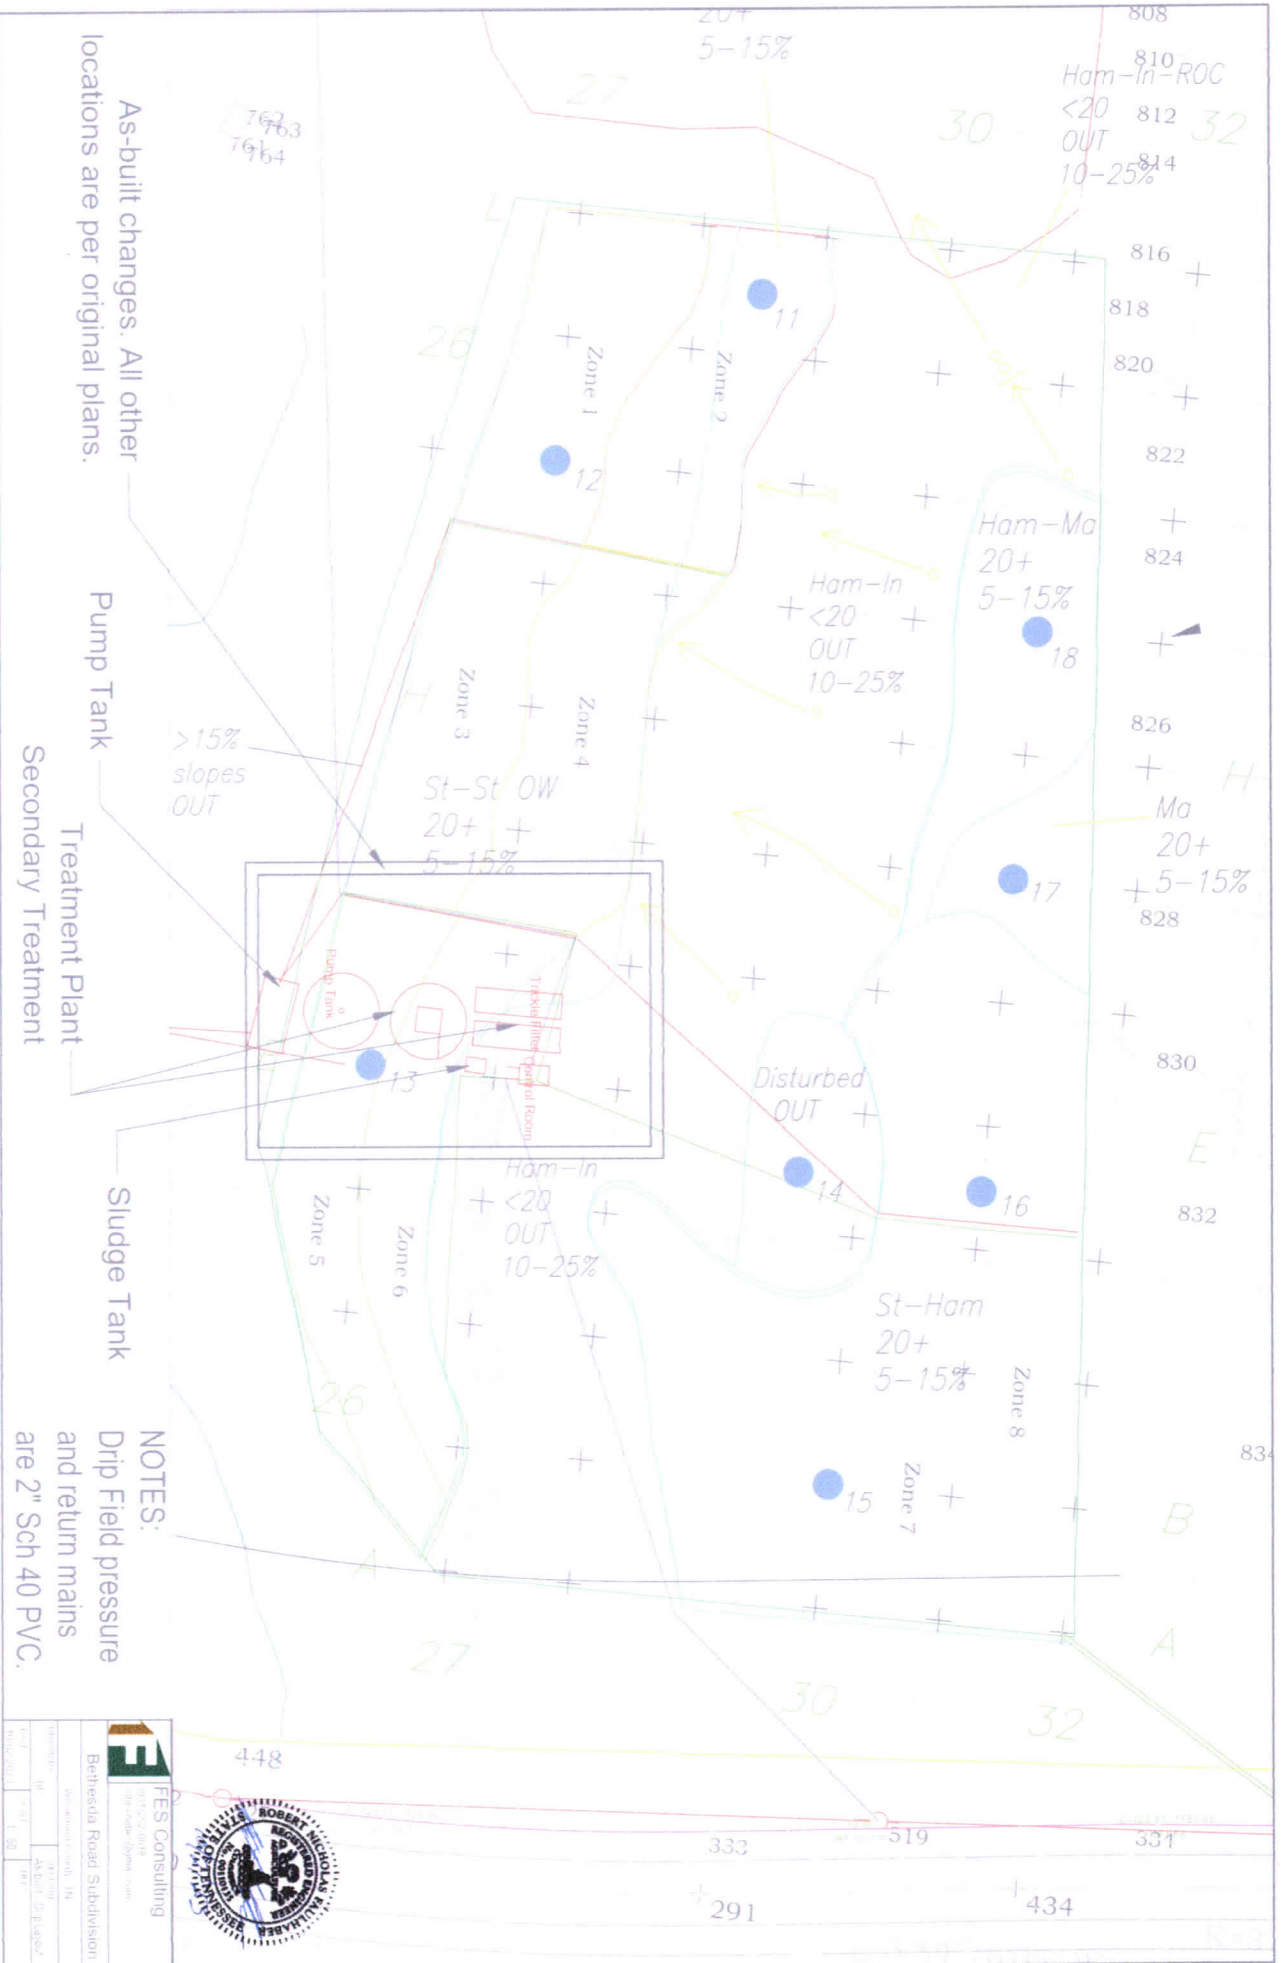

STATE OF TENNESSEE
DEPARTMENT OF ENVIRONMENT AND CONSERVATION
DIVISION OF WATER RESOURCES

William R. Snodgrass - Tennessee Tower
312 Rosa L. Parks Avenue, 11th Floor
Nashville, Tennessee 37243-1102

September 20, 2023
Mr. Dart Kendall
Bethesda Road Subdivision
e-copy: dart@aquagreenutility.com
3350 Galts Road
Acworth, GA 30102

Subject: **Construction Inspection for the Bethesda Road Subdivision**
 Aqua Green Utility Inc.
 Wastewater Project Number: SOP-20016
 County: Williamson

Dear Kendall,

On Tuesday, September 19, 2023, the Division of Water Resources conducted a post construction inspection of the above referenced site. It was determined that the system appears to have been installed in accordance with the plans and specification submitted to the Division.

The project consists of recirculating fixed film trickle filter, UV disinfection and drip dispersal. The system is intended to service a subdivision with a design flow of .0331 MGD.


Fencing was installed and signs were posted according to the regulations.

A copy of the plans showing the exact location of the treatment system, tanks, control building, drip zones, and any additional appurtenances relative to the wastewater treatment system as installed were on site, per the permit requirements. It is recommended that a hard copy of the plans be kept onsite.

If we may be of any assistance, please feel free to contact Mr. Bryan Pope EC at (931) 224-3098 or by E-mail at bryan.pope@tn.gov.

Sincerely,

Bryan Pope

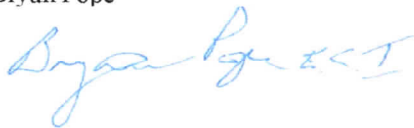A handwritten signature in blue ink, appearing to read "Bryan Pope", with a stylized flourish at the end.

Land-Based Systems Unit
cc: Land-Based System