

Electronically Filed in TPUC Docket  
Room on October 2, 2024 at 8:41 a.m.

October 2, 2024


Mr. David Jones, Chairman  
c/o Ectory Lawless  
Tennessee Public Utilities  
502 Deaderick Street, 4<sup>th</sup> Floor  
Nashville, TN 37243

RE: Docket No. 23-00073 – As Built Drawings

Dear Chairman Jones,


Enclosed please find a copy of the “as built” drawing for the wastewater system at Wyelea subdivision, as required by the order issued in this docket.

Kind regards,

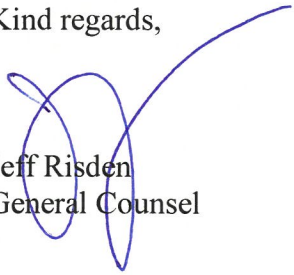


Jeff Riden  
General Counsel



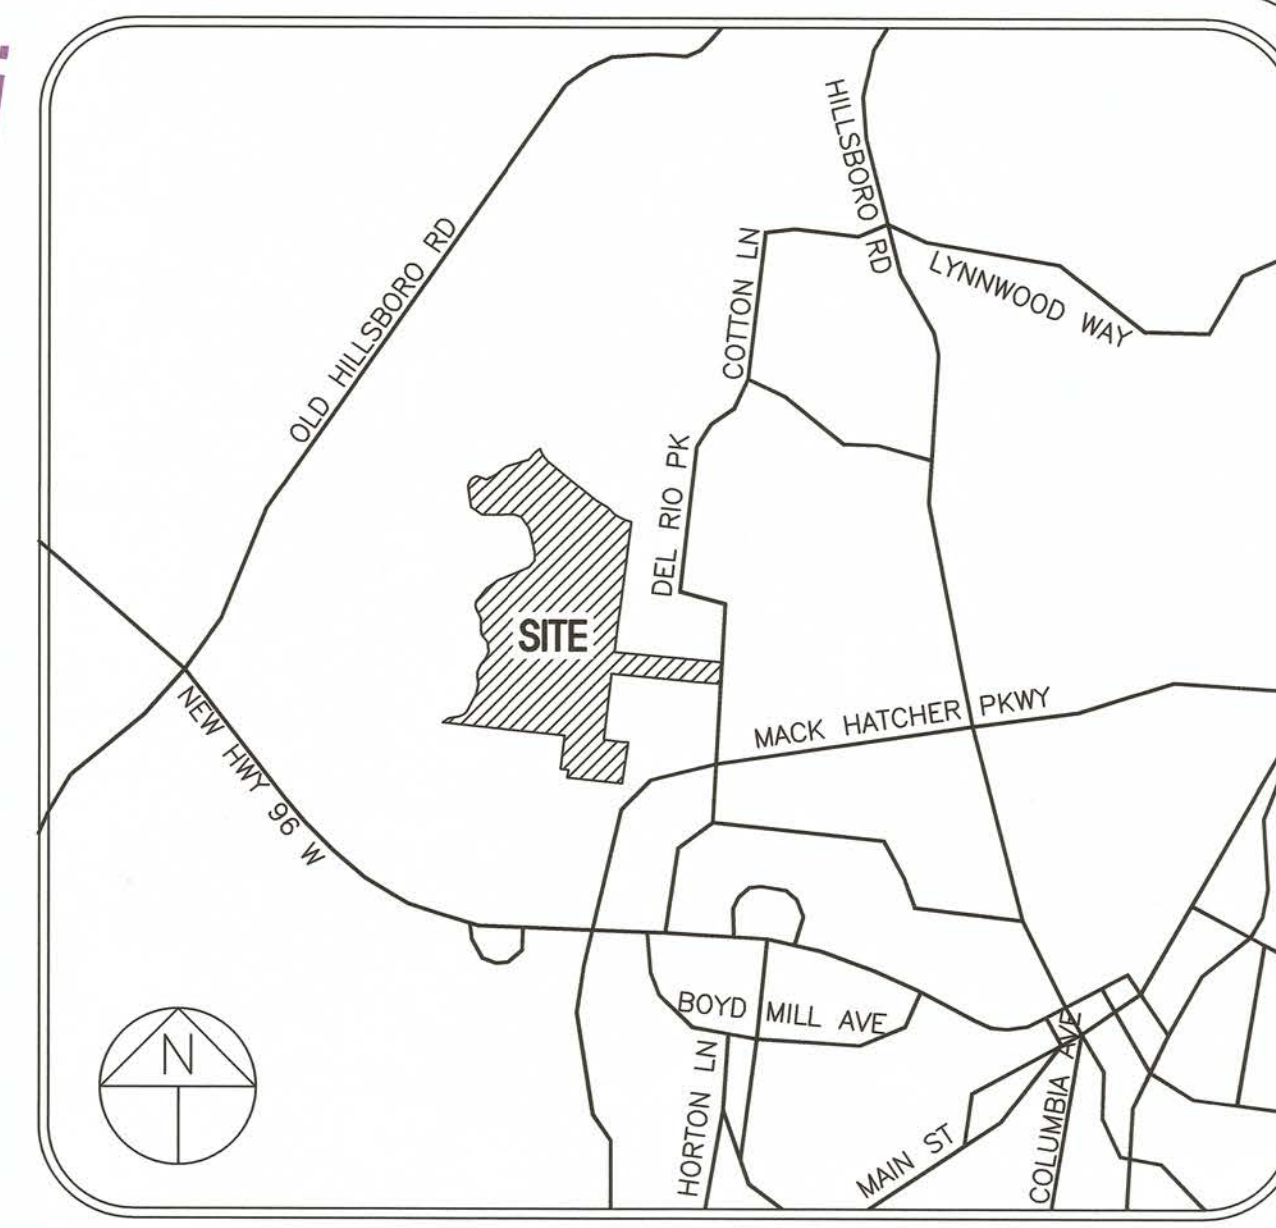


LOCATION MAP  
Not to Scale

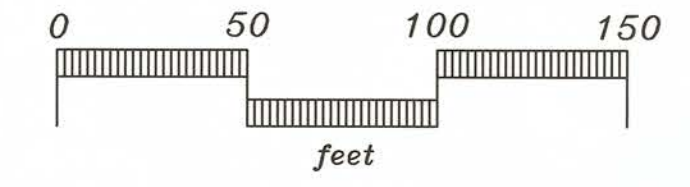

**\* NOTE**  
SEC INC. SURVEYED THE LOCATION (09-17-2024) OF THE FACILITY TO FINALIZE OUR FIELD SURVEY AS-BUILT DRAWING TO VERIFY COMPLIANCE TO APPROVED CONSTRUCTION PLANS FOR WYLEEA FARMS TREATMENT FACILITY. BASED ON OUR OBSERVATIONS AND TO THE BEST OF MY KNOWLEDGE, ADENUS SOLUTIONS GROUP CONSTRUCTION WORK OF THE TREATMENT FACILITY (BIOCLERES, RECIRCULATION TANKS, EQ TANK, CONTROL BUILDING, FINAL DOSE TANK) HAS BEEN COMPLETED IN ACCORDANCE WITH APPROVED PLANS.

**LEGEND**

- ELECTRIC BOX
- DRIP ZONE/DRIP LINES
- RESERVE SOILS
- EXISTING 3" FORCE MAIN(FM) SUPPLY DRIPLINE
- FLUSHING VALVE
- SOLENOID VALVE
- FENCE
- FORCE MAIN RETURN
- MINOR CONTOUR
- MAJOR CONTOUR
- BOUNDARY LINE

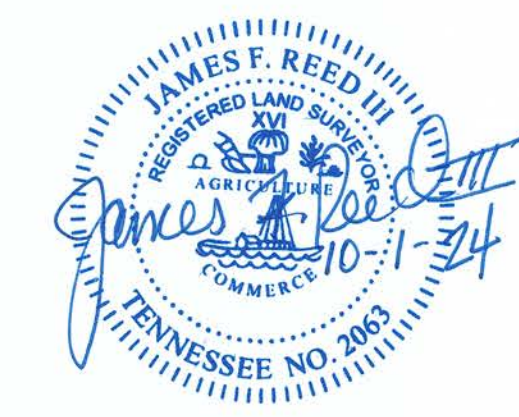

MORE  
DB 5467, PG 800  
TM 064 01101

S.O.P. 23022  
TREATMENT FACILITY RECORD AS-BUILT DRAWING

Step System  
Wyleea Farm  
SUBDIVISION

TENNESSEE  
TAX MAP 51, PARCEL 13.00, IN WILLIAMSON COUNTY

**SEC, Inc.** SITE ENGINEERING CONSULTANTS  
ENGINEERING • SURVEYING • LAND PLANNING  
LANDSCAPE ARCHITECTURE  
850 MIDDLE TENNESSEE BLVD • MURFREESBORO, TENNESSEE 37129  
PHONE (615) 890-7901 • FAX (615) 895-2567

PROJ. # 2214	DATE: 9/26/2024	FILE: WyleeaFormAsBuiltWW	DRAWN BY: TAF	SCALE: 1" = 50'	SHEET 1 OF 1
-----------------	--------------------	------------------------------	------------------	--------------------	-----------------

23-00073

SHORT PROPERTIES  
DB 1137, PG 603  
TM 064 02000

Electronically Filed in TPVC Docket Room on October 2, 2024 at 8:41 a.m.