

BUTLER | SNOW

September 18, 2026

VIA ELECTRONIC FILING

Electronically Filed in TPUC Docket Room
on September 18, 2026 at 12:39 p.m.

Hon. Herbert H. Hilliard, Chairman
c/o Ectory Lawless, Docket Manager
Tennessee Public Utility Commission
502 Deaderick Street, 4th Floor
Nashville, TN 37243
TPUC.DocketRoom@tn.gov

RE: *Application of Two Rivers Utility, LLC for a Certificate of Public Convenience and Necessity*, TPUC Docket No. 25-00073

Dear Chairman Hilliard:

Attached for filing please find *Two Rivers Utility, LLC's Second Report Demonstrating Compliance with Filing Requirements of Order Approving Application for a Certificate of Convenience and Necessary*, in the above-captioned matter.

As required, copies will follow. Should you have any questions concerning this filing or require additional information, please do not hesitate to contact me.

Very truly yours,

BUTLER SNOW LLP



Melvin J. Malone

clw

Attachment

cc: Craig Chrestman, Two Rivers Utility
Joey Wimberley, Two Rivers Utility
Karen H. Stachowski, Esq., Consumer Advocate
Vance L. Broemel, Esq., Consumer Advocate

*Neuhoff Building
1320 Adams Street, Suite 1400
Nashville, TN 37208*

MELVIN J. MALONE
615.651.6705
C 615.948.7801
melvin.malone@butlersnow.com

T 615.651.6700
F 615.651.6701
www.butlersnow.com

BUTLER SNOW LLP

**BEFORE THE TENNESSEE PUBLIC UTILITY COMMISSION
NASHVILLE, TENNESSEE**

IN RE:	)	
	)	
APPLICATION OF TWO RIVERS	)	
UTILITY, LLC FOR A CERTIFICATE	)	DOCKET NO. 25-00073
OF PUBLIC CONVENIENCE AND	)	
NECESSITY	)	

**TWO RIVERS UTILITY, LLC’S
SECOND REPORT DEMONSTRATING COMPLIANCE
WITH FILING REQUIREMENTS OF ORDER APPROVING APPLICATION
FOR A CERTIFICATE OF PUBLIC CONVENIENCE AND NECESSITY**

On March 18, 2026, the Tennessee Public Utility Commission (“Commission” or “TPUC”) issued its Order Approving Application of Two Rivers Utility, LLC for a Certificate of Public Convenience and Necessity (“Order”) in the above-referenced matter.¹ The Order requires Two Rivers Utility, LLC (“Two Rivers”) to file a report on the status of providing wastewater service to Phase 3 of the Canterbury Manor Subdivision, as well as the status of Two Rivers’ compliance with each of the filing requirements.² With this report, Two Rivers is filing the documents referenced below.

Paragraph 1.b. A copy of the State Operating Permit issued by the Tennessee Department of Environment and Conservation is hereby filed as **Exhibit C** to this report.

¹ *Order Approving Application of Two Rivers Utility, LLC for a Certificate of Public Convenience and Necessity*, TPUC Docket No. 25-00073 (March 18, 2026).

² *Id.*, p. 7.

Paragraph 1.c. A copy of the as-built plans is hereby filed as **Exhibit D** to this report.

Respectfully submitted,



Melvin Malone (BPR No. 013874)

Butler Snow LLP

Neuhoff Building

1320 Adams Street, Suite 1400

Nashville, TN 37208

Phone: (615) 651-6700

Melvin.Malone@butlersnow.com

*Attorneys for Applicant Two Rivers Utility,
LLC*

Exhibit C



STATE OF TENNESSEE
DEPARTMENT OF ENVIRONMENT AND CONSERVATION
DIVISION OF WATER RESOURCES

Davy Crockett Tower
500 James Robertson Parkway, 9th Floor
Nashville, Tennessee 37243-1102

May 27, 2026

Mr. Joey Wimberley
Two Rivers Utility, LLC.
e-copy: joeytrufllo@gmail.com
673 West Main Street
Adamsville, TN 38310

Subject: **Startup Inspection – Canterbury Manor, Phase 3**
Two Rivers Utility, LLC.
Wastewater Project Number: 24.0364
State Operating Permit: SOP-24015
County: Fayette

Dear Mr. Wimberley,

On Tuesday, May 20, 2026, staff from the Division of Water Resources conducted a startup inspection of the above-referenced project. This inspection was performed to verify the final installation and operational readiness of the treatment system prior to initiating service.

The startup inspection followed an initial construction inspection conducted on April 22, 2026, during which the septic/pump tanks and low-pressure pipe (LPP) disposal field installation were observed and appeared to be consistent with revised plans subsequently approved by the Division on May 5, 2026.

During the May 20, 2026, startup inspection, Division staff observed that all six LPP disposal field zones were installed, accessible, and ready for operation. Individual lines in each zone were observed to be set to the required three feet of pressure head.

The project consists of a decentralized LPP system serving a 23-lot development with a design flow of 6,900 gallons per day. It is recommended that a copy of plans showing the precise location of tanks, the control building, disposal field zones, and all associated appurtenances be kept on site.

Based on the findings of the May 20, 2026 startup inspection, the Division hereby approves startup of the wastewater treatment system for Canterbury Manor, Phase 3.

Please be aware, this shall not be construed as creating a presumption of correct operation or as warranting by the commissioner that the approved facilities will reach the designed goals.

Furthermore, the operation of this system must comply with all applicable requirements of State Operating Permit SOP-24015 and the Tennessee Water Quality Control Act.

If you have questions, please feel free to contact Bradley Smith at (731) 234-1408 or by E-mail at bradley.e.smith@tn.gov.

Sincerely,

A handwritten signature in blue ink that reads "Angela Jones". The signature is written in a cursive, flowing style.


Angela Jones P.E. CPM
Manager, Engineering Services Unit

cc: Land-Based System

NOTES:


1. LPP LATERALS TO BE ON EXACT CONTOURS, TO BE DETERMINED DURING INSTALLATION.
2. ALL CONSTRUCTION AND MATERIALS TO BE IN ACCORDANCE WITH STATE OF TENNESSEE REGULATIONS.

SPECIAL NOTE TO INSTALLER:
TDEC WILL REQUIRE INSTALLER TO
FLAG OUT PRIMARY & RESERVE AREAS PER SKETCH.

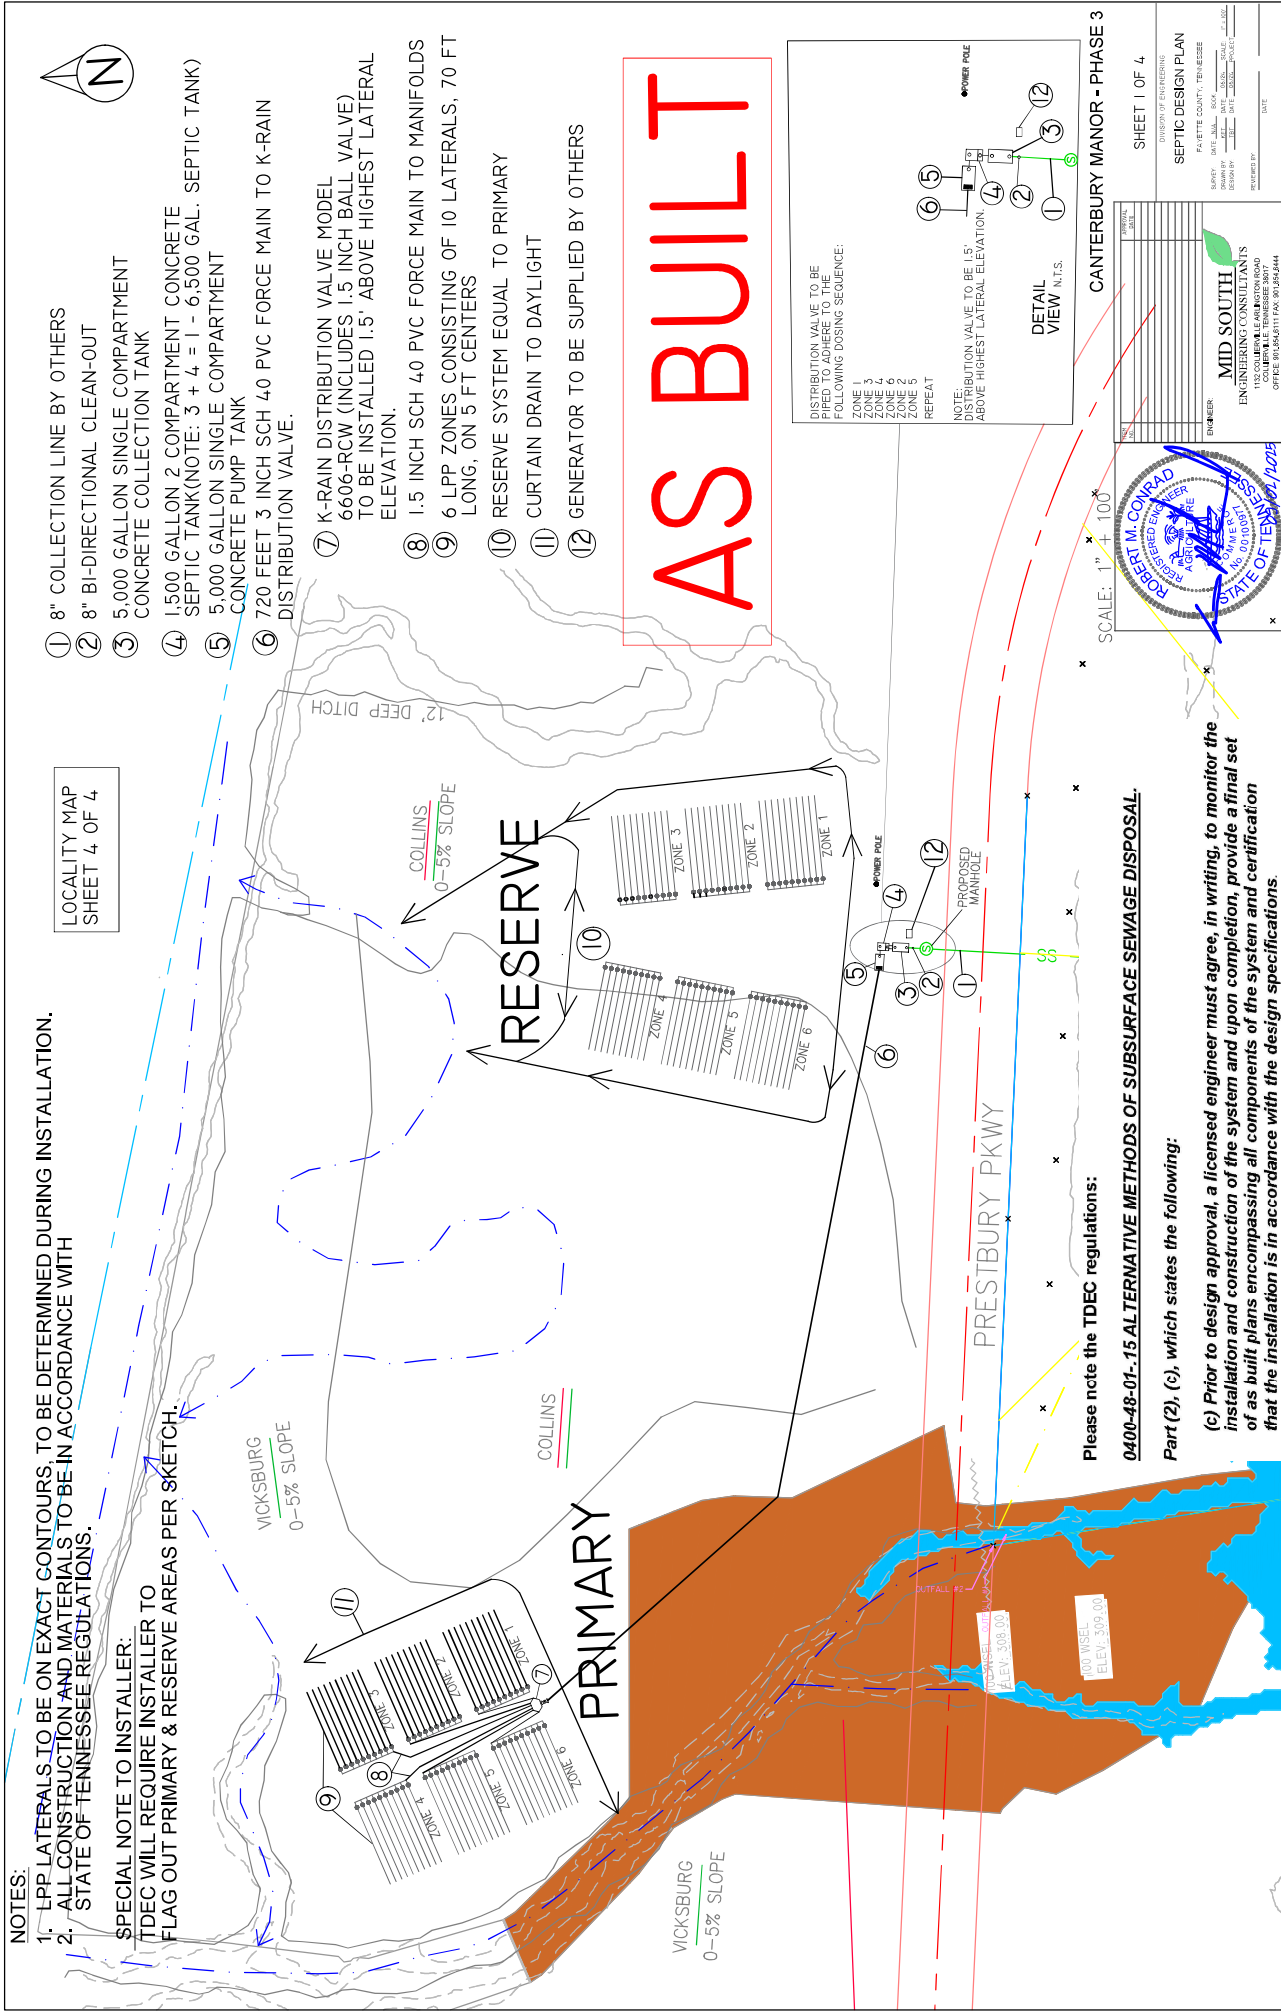

- 
- ① 8" COLLECTION LINE BY OTHERS
 - ② 8" BI-DIRECTIONAL CLEAN-OUT
 - ③ 5,000 GALLON SINGLE COMPARTMENT CONCRETE COLLECTION TANK
 - ④ 1,500 GALLON 2 COMPARTMENT CONCRETE SEPTIC TANK(NOTE: 3 + 4 = 1 - 6,500 GAL. SEPTIC TANK)
 - ⑤ 5,000 GALLON SINGLE COMPARTMENT CONCRETE PUMP TANK
 - ⑥ 720 FEET 3 INCH SCH 40 PVC FORCE MAIN TO K-RAIN DISTRIBUTION VALVE.
 - ⑦ K-RAIN DISTRIBUTION VALVE MODEL 6606-RCW (INCLUDES 1.5 INCH BALL VALVE) TO BE INSTALLED 1.5' ABOVE HIGHEST LATERAL ELEVATION.
 - ⑧ 1.5 INCH SCH 40 PVC FORCE MAIN TO MANIFOLDS
 - ⑨ 6 LPP ZONES CONSISTING OF 10 LATERALS, 70 FT LONG, ON 5 FT CENTERS
 - ⑩ RESERVE SYSTEM EQUAL TO PRIMARY
 - ⑪ CURTAIN DRAIN TO DAYLIGHT
 - ⑫ GENERATOR TO BE SUPPLIED BY OTHERS

AS BUILT

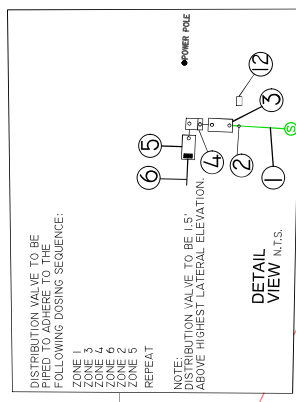

SCALE: 1" = 100'

CANTERBURY MANOR - PHASE 3

ERIM.CO.





DATE: 10/1/01

PROJECT: 10/1/01

SHEET 1 OF 1


(c) Prior to design approval, a licensed engineer must agree, in writing, to monitor the installation and construction of the system and upon completion, provide a final set of as built plans encompassing all components of the system and certification that the installation is in accordance with the design specifications.

[illegible]

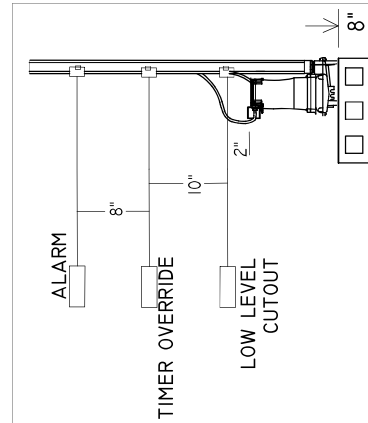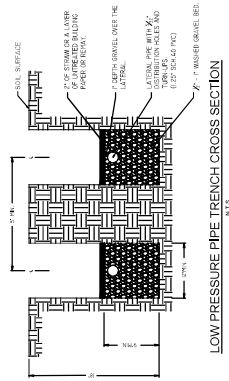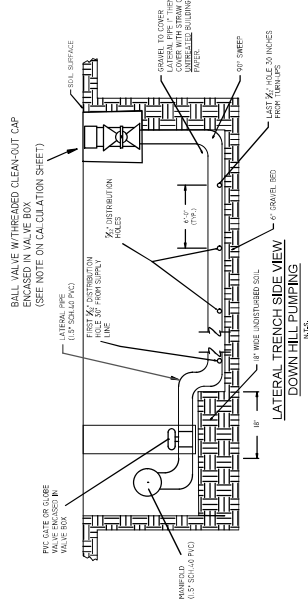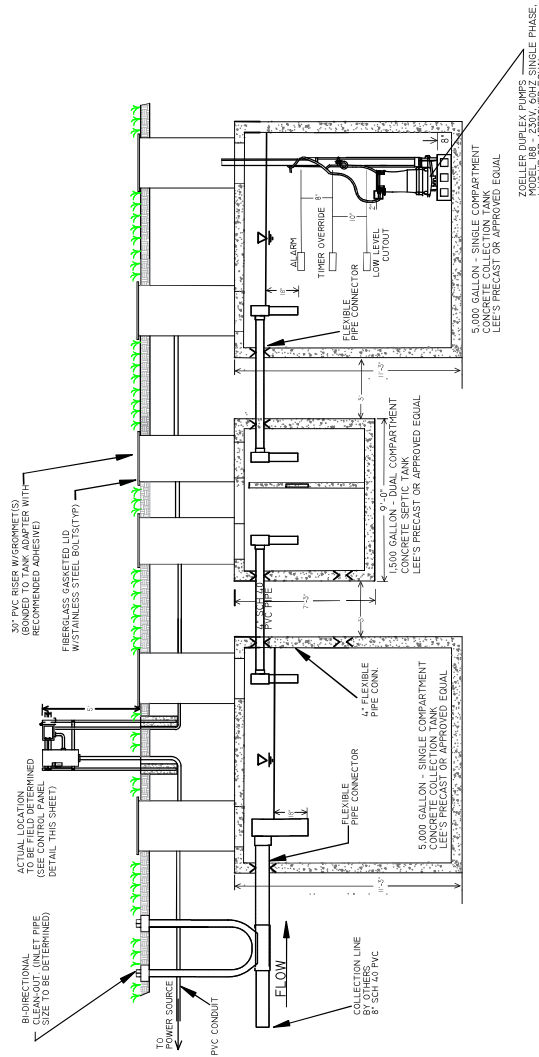

7 MIN. RUN TIME
73 MINS OFF

THREE FLOAT SYSTEM WITH TIMER OVERRIDE

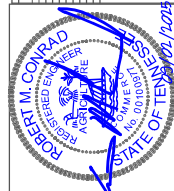

SHEET 3 OF 4

DIVISION OF ENGINEERING


SEPTIC DESIGN PLAN
 FAYETTE COUNTY, TENNESSEE

SURVEY: DATE: N/A BOOK: _____

DRAIN BY:	KEY	DATE	SCALE	NET
DESIGN BY:	TOT	DATE	02/24	190.5CT

Downloaded from <http://ajphaphysocpharm.sagepub.com/> at 11:06 11 May 2015

REVIEWED BY: _____ DATE: _____

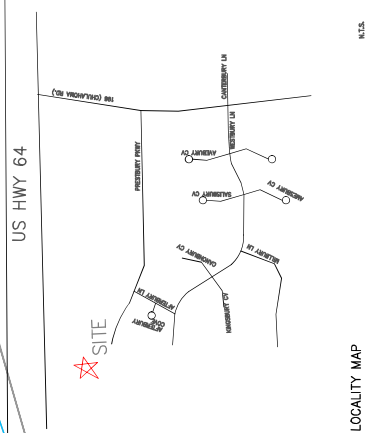

SUBDIVISION LAYOUT
FOR REFERENCE

CANTERBURY LN
CANTERBURY MANOR - PHASE 3

SHEET 4 OF 4

DIVISION OF ENGINEERING

SEPTIC DESIGN PLAN

FAYETTE COUNTY, TENNESSEE


DESIGNED BY: DATE: SCALE: A.S.T.

CHECKED BY: DATE: SCALE: A.S.T.

REVIEWED BY: DATE: SCALE: A.S.T.

DATE: SCALE: A.S.T.

MID SOUTH
ENGINEERING CONSULTANTS
1132 COLLETTA AVE. SUITE 100
COLUMBIA, TENNESSEE 38401
OFFICE: 661-244-1111 FAX: 661-244-1112

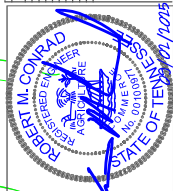


CERTIFICATE OF SERVICE

I hereby certify that a true and correct copy of the foregoing was served via U.S. Mail or electronic mail upon:

Karen H. Stachowski, Esq.
Deputy Attorney General
Office of the Tennessee Attorney General
Consumer Advocate Division
P.O. Box 20207
Nashville, TN 37202-0207
Karen.Stachowski@ag.tn.gov

Vance L. Broemel, Esq.
Senior Assistant Attorney General
Office of the Tennessee Attorney General
Consumer Advocate Division
P.O. Box 20207
Nashville, TN 37202-0207
Karen.Stachowski@ag.tn.gov

This the 18th day of September 2026.

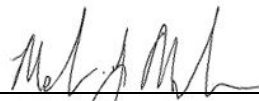

Melvin J. Malone